

## SNIFFER CIRCUIT DESCRIPTION

Author: C.R.Read  
Date: 10/25/84  
File: //users/crr/docs: sniffer

LEONARD SHUSTEK  
OCT 29 1984

### GENERAL DESCRIPTION

The SNIFFER circuit is an add-on daughter board to Nestar's IBM-PC NIC. Its purpose is to "massage" each data packet from the network before it reaches the RIM so that every data packet looks like a broadcast. This fools the RIM into accepting every data packet irrespective of its destination address (DID). Because of the operation of the RIM, only the first of the two DIDs need be zeroed, which fortunately leaves the second to be loaded into the buffer intact. As the data has been modified, the CRC check within the RIM will fail and the RI status bit will not be asserted, so that the SNIFFER must generate its own "Packet Received" signal. This signal may be either polled by software or may generate an interrupt, these alternatives being under software control.

### CIRCUIT DESCRIPTION (see Figure 1)

The circuit is initialised by the IDLE PERIOD TIMEOUT CIRCUIT after 6.25 $\mu$ S of inactivity on the network. On ARCNET there is a guaranteed idle period between every transmission of 12.6 $\mu$ S. Reflections from an unterminated, maximum length (2000 feet) RG 62 cable will settle within 4.9 $\mu$ S. So detecting 6.25 $\mu$ S of inactivity will ensure that a reliable RESET signal is generated between every packet. The RESET signal is cleared by the first data bit on the RX serial data line into the RIM.

The START OF HEADER (SOH) DETECTOR discriminates between the wanted data packets and the other four unwanted types of packets which occur on ARCNET. [see Token Passing Protocol Boosts Throughput in Local Area Networks - by John A. Murphy - Electronics, September 8th, 1982]

The SOH DETECTED signal from this circuit initiates a 1 byte delay in the DID SYNC circuit which then generates a PACKET signal which is synchronous to the beginning of the DID byte. The DID BLANKING COUNTER generates the correct length blanking pulse (KILL) which is fed back to the NIC to gate out the DID byte into the RIM.

The PACKET signal is cleared by the RESET signal 6.25 $\mu$ S into the next idle period. The falling edge of PACKET then sets a latch which sets a flag or pulls an interrupt in the NIC to indicate that a complete packet has been received.

### IDLE TIMEOUT CIRCUIT

This circuit behaves like a re-triggerable monostable with a period of 6.25 $\mu$ S. It comprises 2 cascaded divide by 5 counters followed by a divide by 2. The counter chain is cleared (active high reset) by the positive pulses on the RIMRX signal from the TRANSCEIVER which occur whenever there is activity in the network. After the last bit of a packet, the counter will start counting up but will lock-up when the count reaches 25 (half of full count) when the inverted MSB (RESET) will inhibit the 4 MHz clock. The RESET signal then will occur 25 x 0.25 $\mu$ S or 6.25 $\mu$ S after the last network activity.

## **DATA CLOCK GENERATOR**

The data clock (CA) into the RIM is essentially a 5 MHz square wave, interrupted at the end of each byte by the data synchronisation signal (DSYNC) from the RIM. To generate a synchronous data clock (DCLK) for the sniffer the CA is divided by 2 by a J/K which is cleared by DSYNC. This produces a sequence of 9 pulses, in which the first 8 positive going edges occur in the middle of the data bits in the byte.

## **START OF HEADER DETECTOR**

The first byte after the ALERT BURST (6 one-bits) is one of five packet-type control characters. For a DATA PACKET this character is an ASCII SOH which is unique in having 7 contiguous zeros. This is detected by shifting the inverted data from the TRANSCEIVER into an 8 bit shift register and ANDing 7 adjacent bits. The output of the AND gate is latched by the transceiver clock (CA) into a J/K. The output of this (SOH DETECTED) enables the DID synchronisation circuit. This circuit originally detected 4 contiguous ones of the ALERT BURST before recognising the SOH character, which accounts for the XOR data inverter. However this caused problems of "lost packets" and so was modified. [see the appendix - SNIFFER HARDWARE PROBLEMS].

## **DID SYNCHRONISATION CIRCUIT**

After a SOH character has been recognised a check must be made that there are subsequent valid bytes, to eliminate false triggering by the idle period that follows one of the other types of packet. This is done by counting 2 further rising edges of the DSYNC signal. DSYNC clocks a D-type divide by 2 whose output then clocks a "1" into a latch. The output of this latch (PACKET) determines the start of the first DID byte.

## **DID BLANKING COUNTER**

There are 9 data clock (DCLK) edges to every byte so the byte length signal is generated by clocking PACKET through a 9 bit shift register (an 8-bit S/R plus a F/F) with the negative edges of DCLK. The inverted output of this S/R is ANDed with PACKET to produce the blanking signal. This signal is then gated with the software controlled SNIFF signal to produce the KILL signal. KILL is fed back to the NIC to control the gate which blanks out the DID in the serial data line into the RIM. The SNIFF control allows the SNIFFER to behave like a normal NIC.

## **PACKET RECEIVED LATCH**

The packet received signal (SNIFFINT) which flags the end of a data packet is generated by setting a latch with the falling edge of PACKET which will occur when the system is reset by the idle period timeout circuit. The output of the latch is also gated with SNIFF to generate SNIFFINT before being fed back to the NIC.



NESTAR CONFIDENTIAL

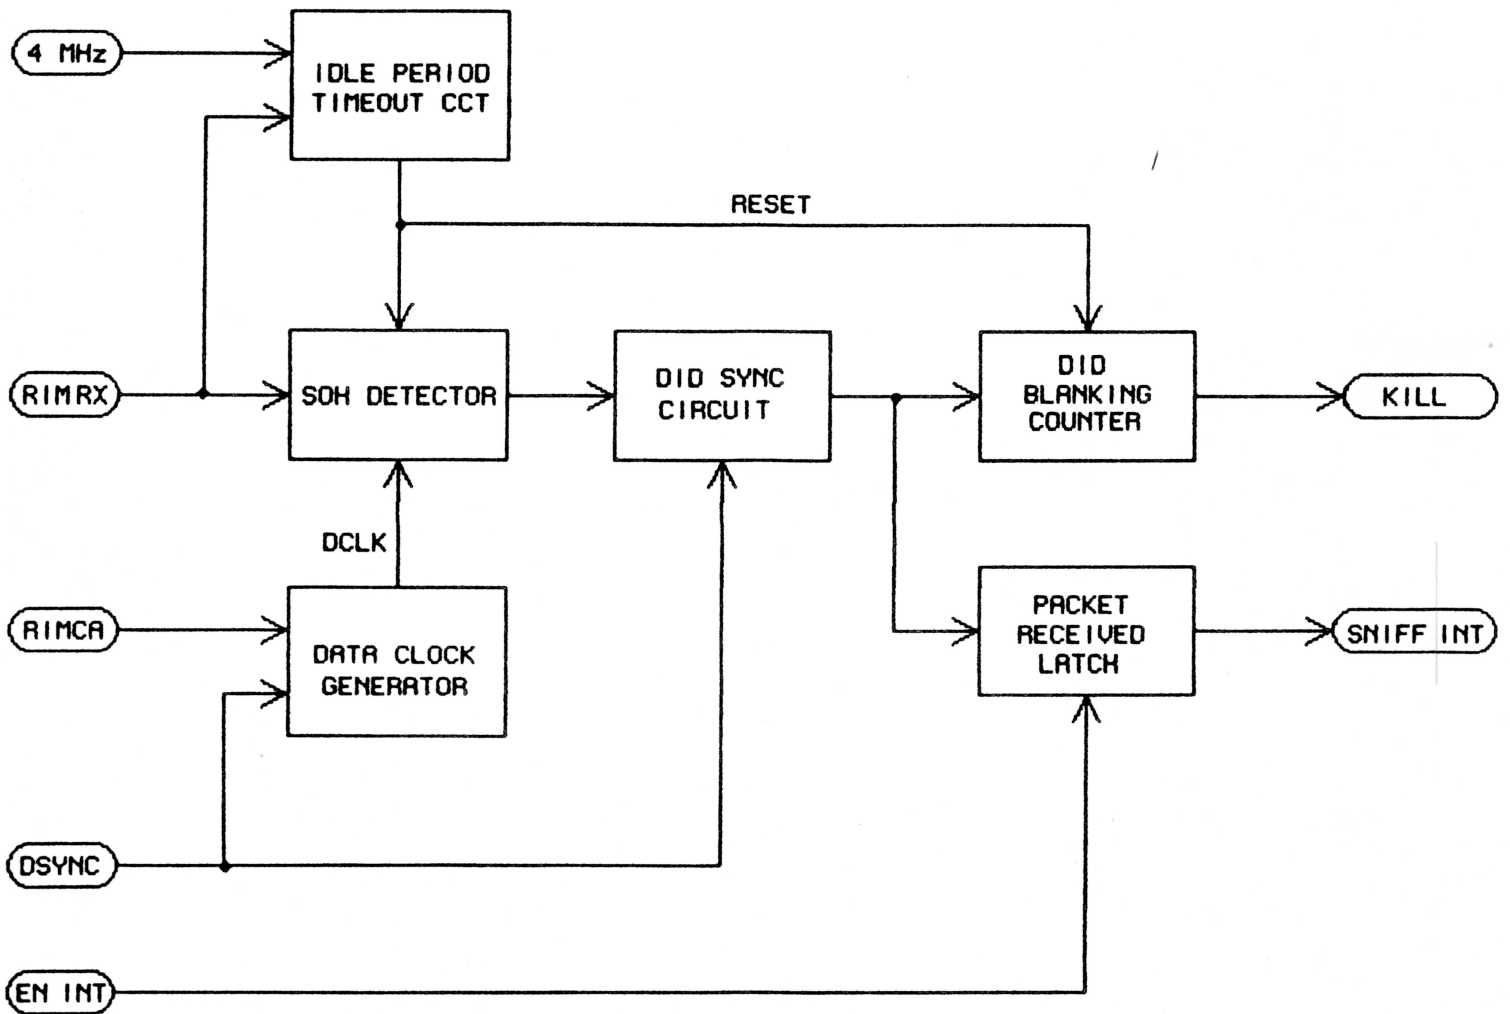


FIGURE 1 SNIFFER BLOCK DIAGRAM

## APPENDIX – SNIFFER HARDWARE PROBLEMS

Author: Chris Read  
Date: 6/4/84  
File: //users/crr/docs:snifmods

### INTRODUCTION

There are two hardware problems with the Sniffer hardware (revision - 001). Firstly, certain sniffer addresses were known to produce false triggering, and it was thought that it occurred when the token was received. Secondly, a small percentage of data packets were being missed by the Sniffer.

### FALSE TRIGGERING

a) The data packet detection circuit looks for a string of 7 contiguous zeros after the ALERT burst. This will detect the Data Packet control character (SOH = \$01) but none of the other 4 control characters (EOT, ENQ, ACK or NACK). Following the SOH DETECTED signal the circuit requires 2 rising edges of DSYNC (the byte synchronising signal from the RIM) to generate a PACKET DETECTED signal.

Because the SOH only looks for 7 contiguous zeros, a destination address (DID) of \$80 or \$01 in any Token or Free Buffer Enquiry will trigger the SOH detector circuitry. The RIM however will only generate one DSYNC pulse after the first (triggering) DID and so will not generate a PACKET DET interrupt signal. BUT, if the token is addressed to the RIM it generates 2 extra DSYNC pulses and thus generates a false PACKET detected interrupt !

b) Again because the SOH detector only looks for 7 zeros, there will be a SOH DET at the end of EVERY data transmission after the data has ended. This normally doesn't matter because there are no DSYNCs. However, two factors combine to produce false triggering. If the last 6 or 7 bits of the Sniffer's station address are zero (\$01, \$02 or \$03) then this final SOH will occur earlier and will just get caught by the first of the extra DSYNCs and then by the second extra DSYNC causing the false PACKET detection.

Various Sniffer station addresses were tried (eg C0, C1, 11 & 81) but no problems were detected either when running the Sniffer program or observed on the Logic State Analyser. Only Sniffer station addresses \$01, \$02, \$03 and \$80 will cause false triggering when the token comes around.

## **MISSED PACKETS**

The Sniffer ALERT detector circuit, which starts the packet detection sequence, looks for a sequence of 4 contiguous '1's following an IDLE timeout. This was chosen because it was thought that the RIM also triggered on the first 4 '1's and it would protect against spurious activity on the line.

However, the RIM sometimes triggers after only 2 or 3 bits of the Alert burst which causes it to drop its DSYNC signal early, with unfortunate results.

The data clock of the Sniffer (DCLK) is generated by dividing the RIM's CA by 2 and gating it with DSYNC, so when DSYNC goes low DCLK is inhibited. So in the case where the RIM detects the Alert burst early, the ALERT detector circuit does not get the required number of clock pulses and thus fails to trigger.

There is one saving factor, which is that if DSYNC drops after only 3 bits of the Alert burst of a DATA PACKET, the next bit clocked into the Alert detector circuit will be the '1'(LSB) of the SOH character and so the circuit will trigger, although late. This reduces the probability of missing Data Packets (which are the only ones we are interested in).

The probability of an 'early' DSYNC seems to be dependent on the time delay between messages on the line and can be made to vary by changing the number of stations or the propagation delay in the line (by adding a HUB for example), it is therefore not predictable or controllable.

## **ENABLING THE SNIFFER IN THE MIDDLE OF A DATA PACKET**

I was thought that if the Sniffer was enabled in the middle of a data packet then the sequence '4 x ones' followed some time later by '7 x zeros' was likely to occur and cause false triggering.

This cannot happen because the ALERT and SOH detection must occur within the first 3 bytes otherwise the KILL signal will not be generated and therefore the RIM will not be fooled into thinking it had a broadcast. It will therefore not generate DSYNC pulses after the 4th byte.

## **RECOMMENDATIONS**

The problem of false triggering only occurs with addresses \$01, \$02, \$03 & \$80 and therefore can be prevented by prohibiting them.

The problem of missing data packets due to 'early' DSYNC pulses can be solved by a simple modification to the circuit (see below).

This modification will enable the ALERT detector immediately after any activity on the line (ie when the RESET signal is lifted). This should be safe against spurious pulses on the line because of the 2 stage filtering in the HYBRID and the TRANCEIVER.


## **HARDWARE MODIFICATION**

Cut trace between IC 3 pin 2 and IC 6 pins 1,8 just above IC 3 pins 1,2.

Link IC3 pin 2 to pull-up on IC 3 pin 11.


This modification may be possible on potted versions (by carefully removing the potting under IC 3) and can easily be done on un-potted boards.

This modification has been incorporated into the -002 revision of the PC boards.

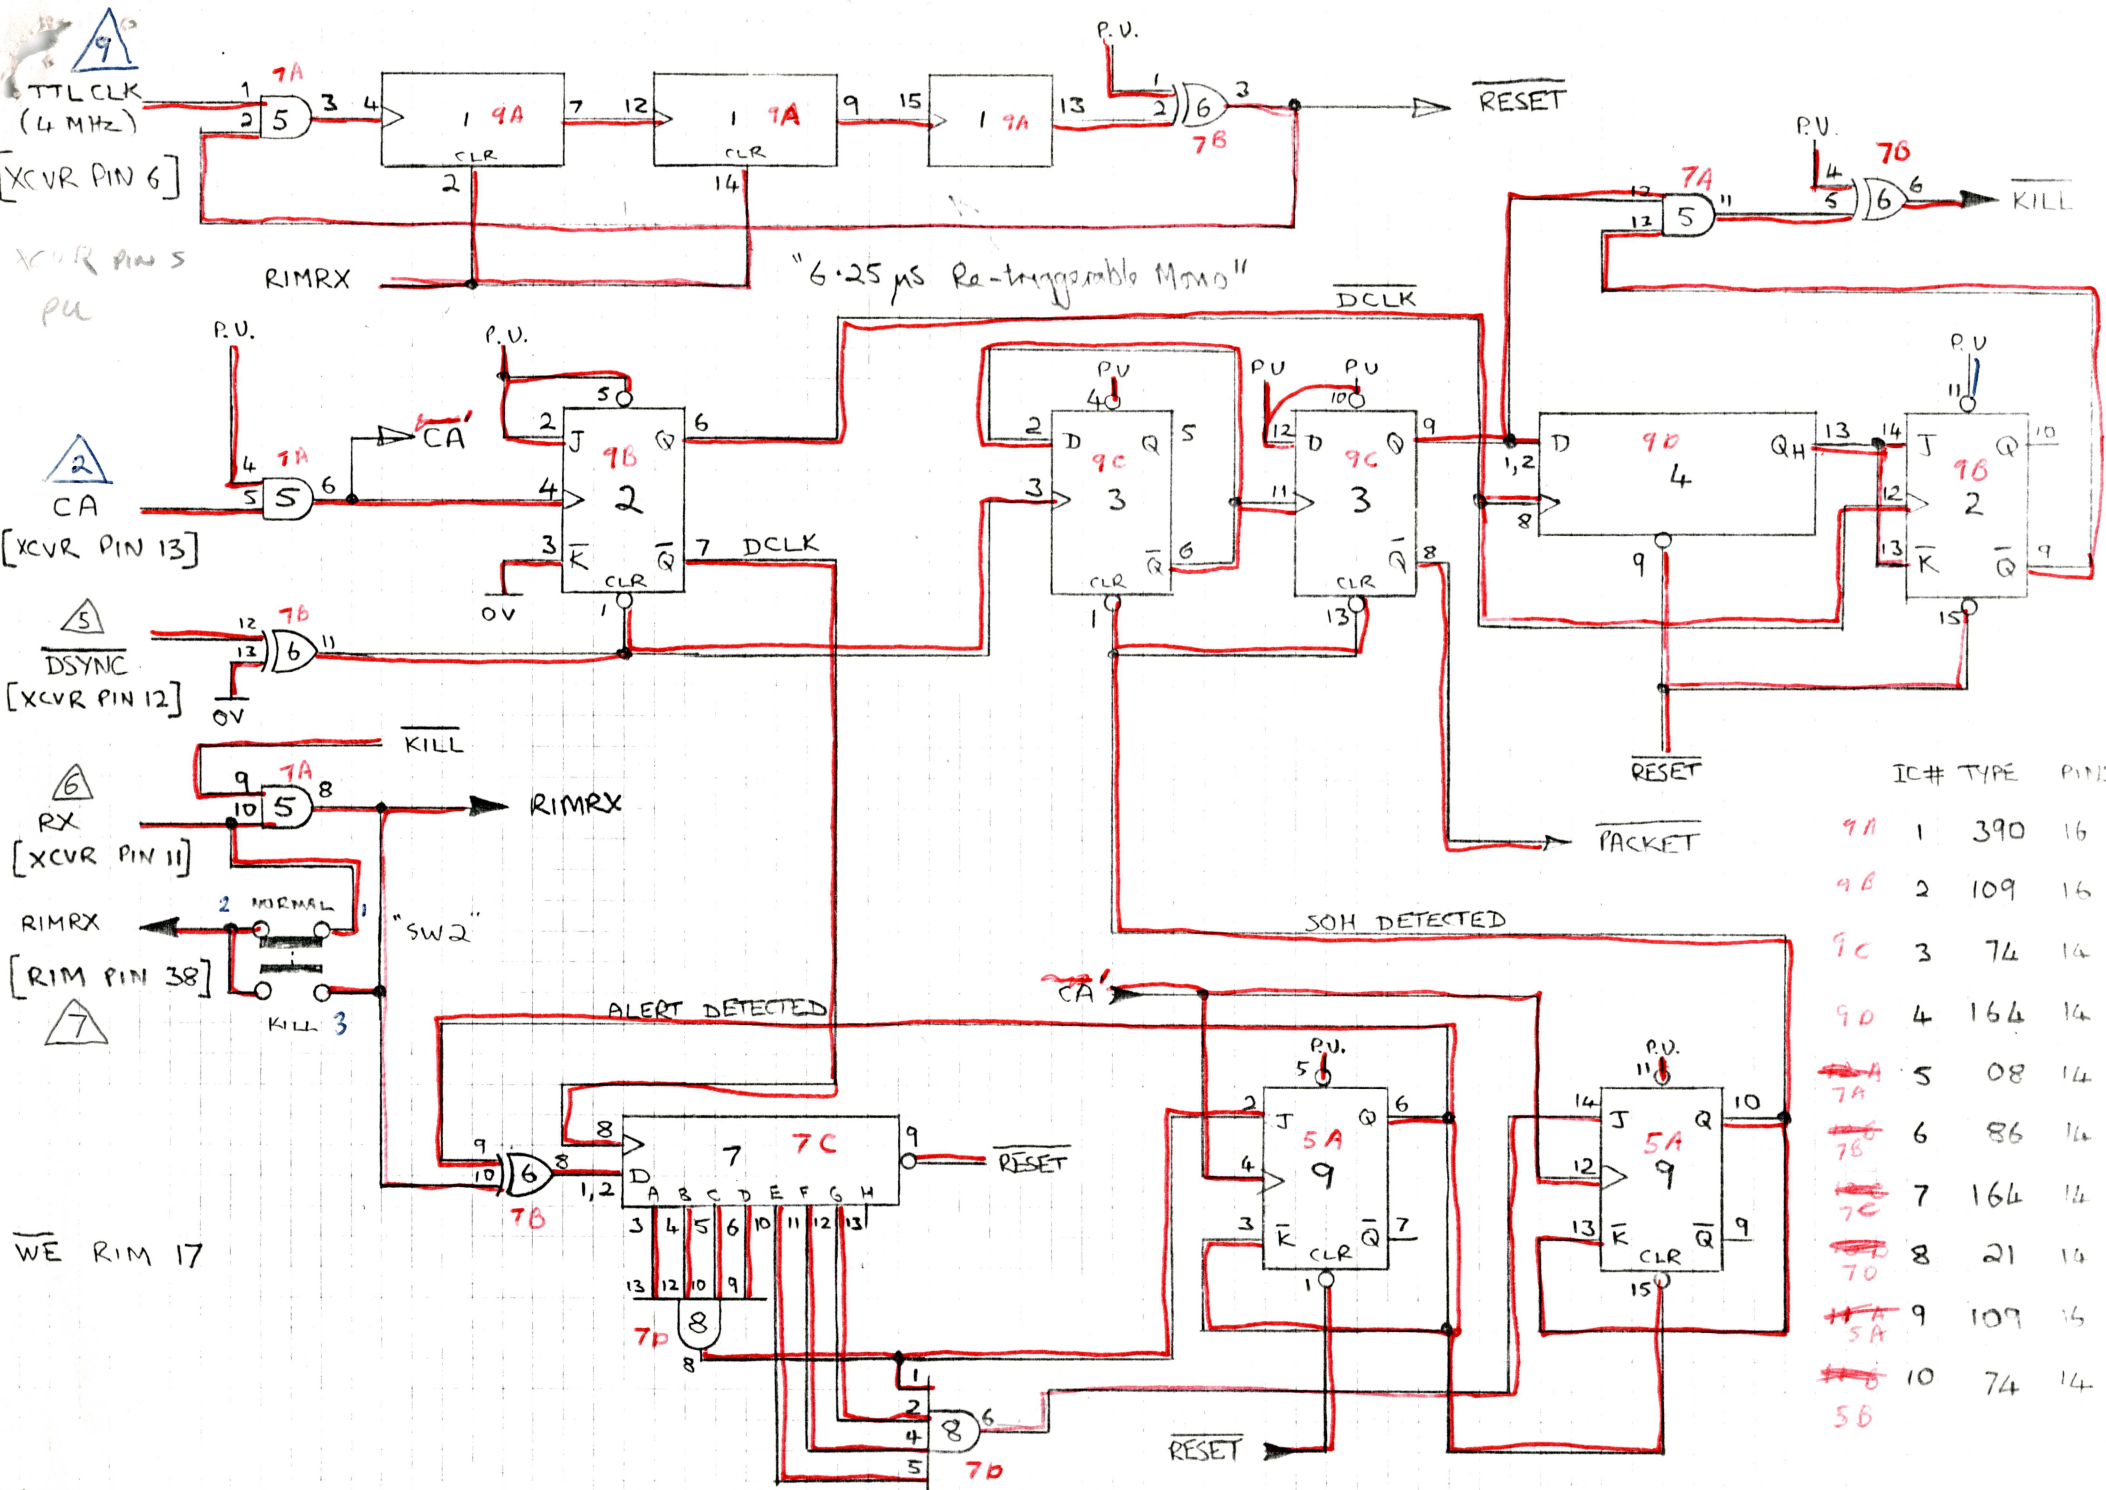

IC#	TYPE	PINS
9A	1	390 16
9B	2	109 16
9C	3	74 14
9D	4	164 14
<del>7A</del>	5	08 14
<del>7B</del>	6	86 14
<del>7C</del>	7	164 14
<del>7D</del>	8	21 14
<del>5A</del>	9	109 16
<del>5B</del>	10	74 14




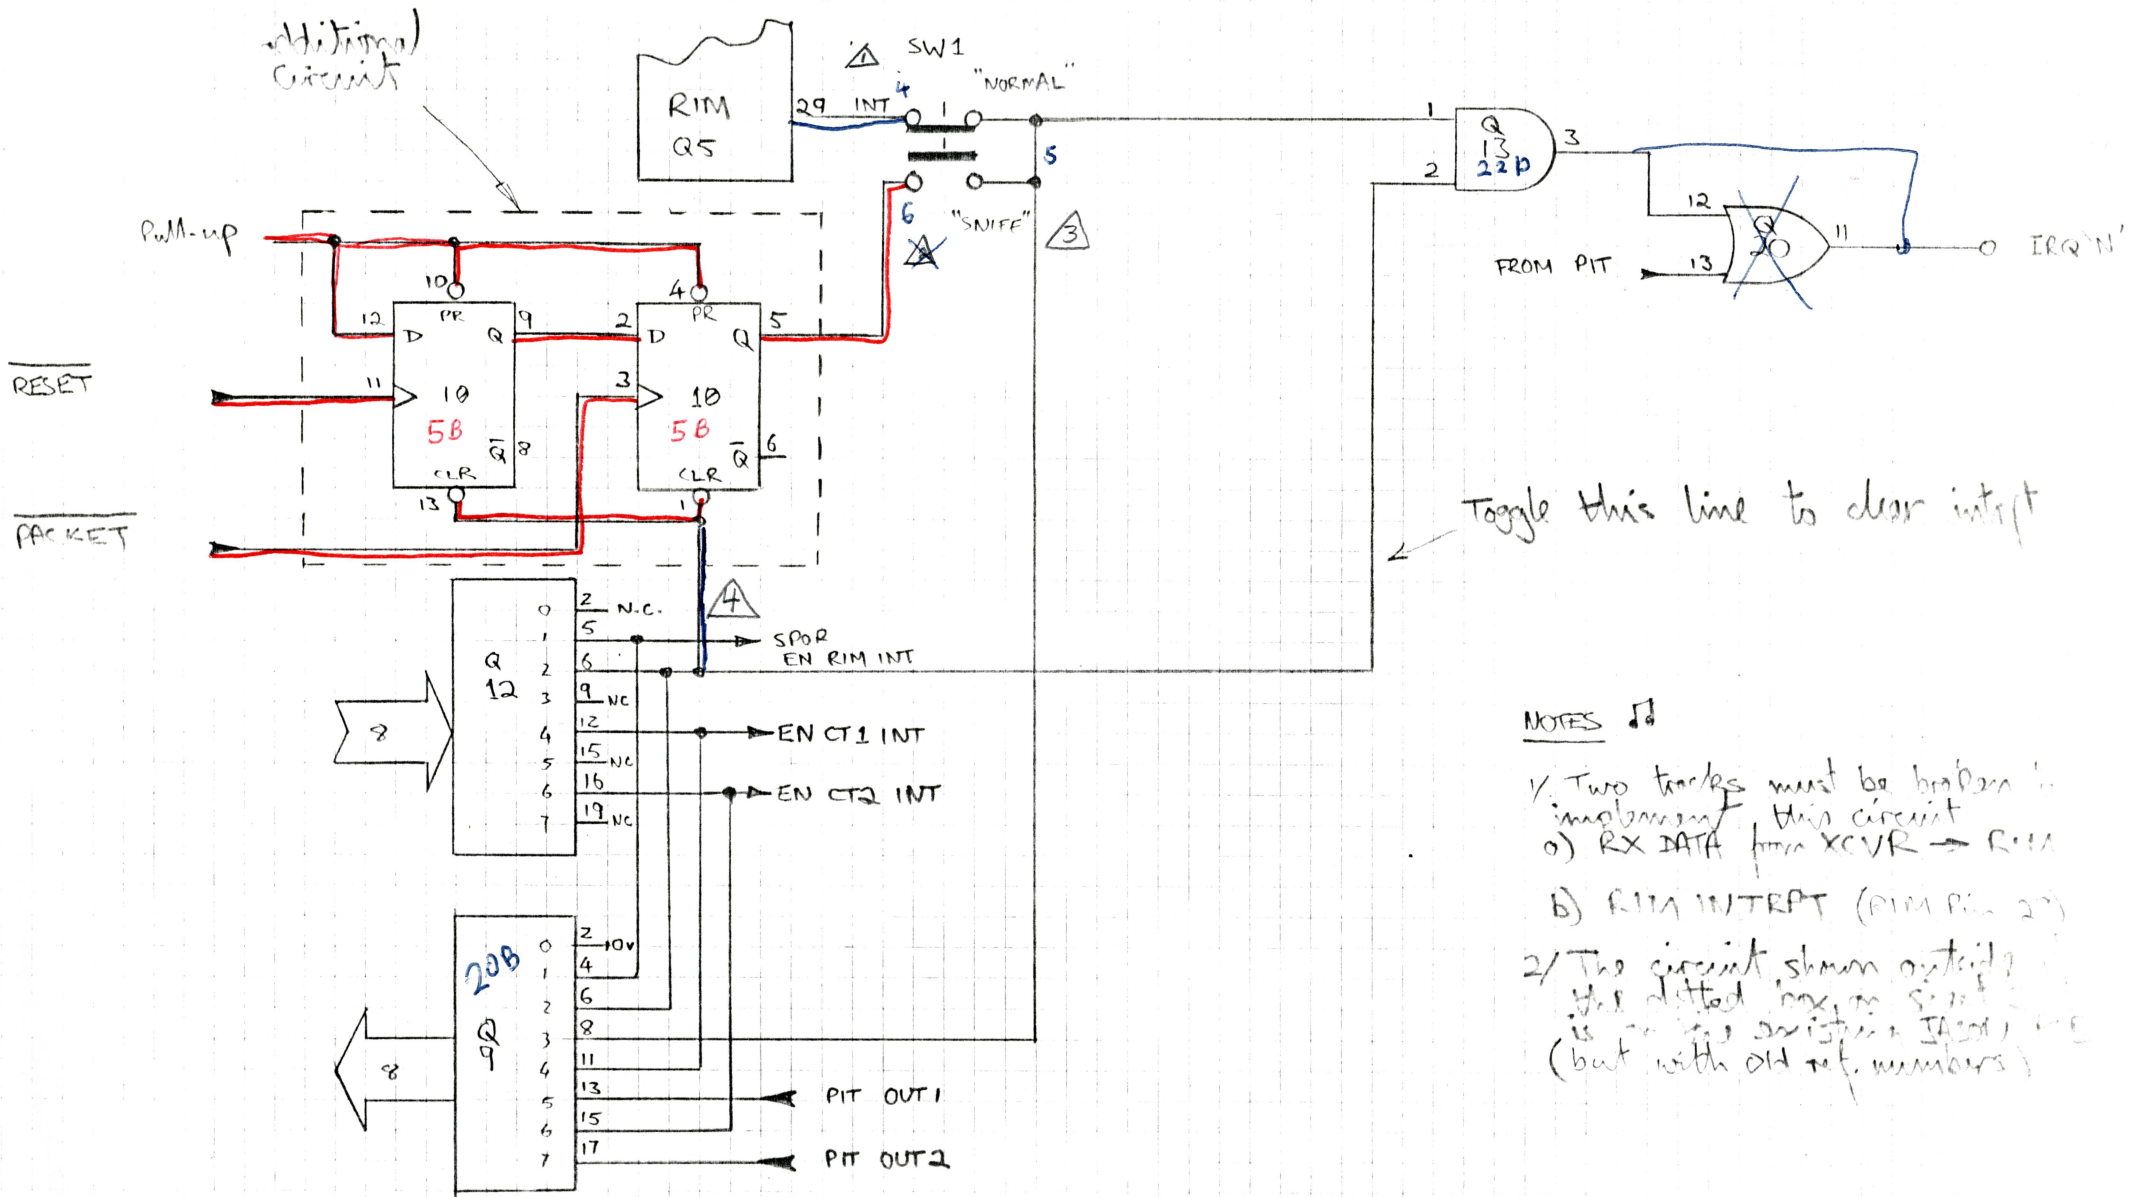


NOTES

- Two tracks must be broken to implement this circuit
  - RX DATA from XCVR → RIM
  - RIM INTPT (RIM pin 29)
- The circuit shown outside the dotted box, on S-21, is the original circuit (but with old ref. numbers)

200 nS / Div

REVISIONS			
LTR	DESCRIPTION	DATE	APPROVED

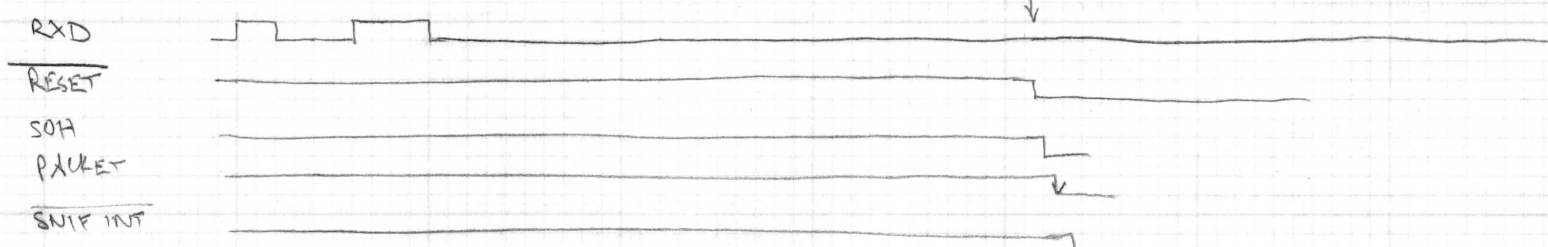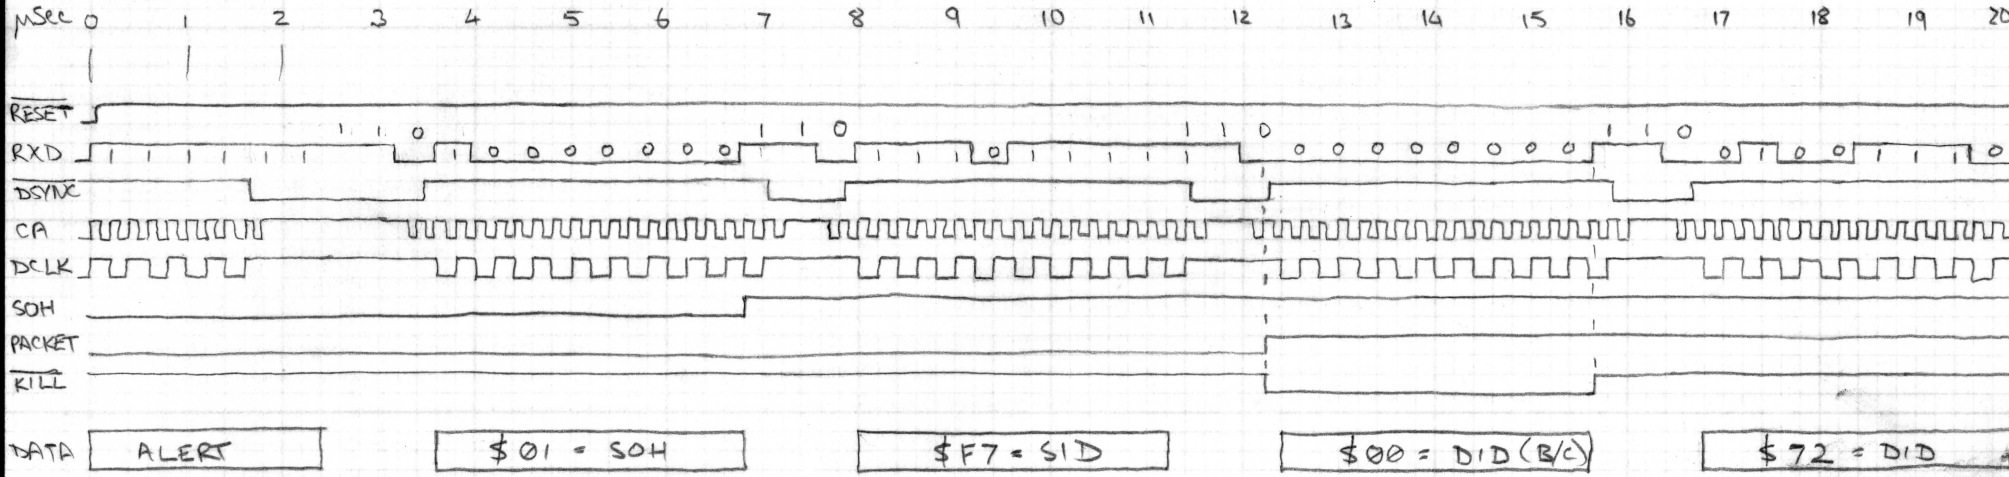

NOTE THE FIRST 'DID' IS CLAMPED TO ZERO WHICH FOOLS THE RIM INTO THINKING IT IS A BROADCAST. THE SECOND DID IS LOADED INTO RAM BY THE RIM WHERE IT CAN BE READ



TOLERANCES UNLESS OTHERWISE SPECIFIED			SNIFFER WAVEFORMS		
FRACTIONS	DEC	ANGLES	'SNIFFED' DATA PACKET		
±	±	±			
APPROVALS	DATE				
DRAWN					
CHECKED			SCALE	SIZE	DRAWING NO.
				<b>A</b>	
DO NOT SCALE DRAWING				SHEET 1 of 3	



SCALE = 200µS/div

REVISIONS

LTR	DESCRIPTION	DATE	APPROVED
-----	-------------	------	----------

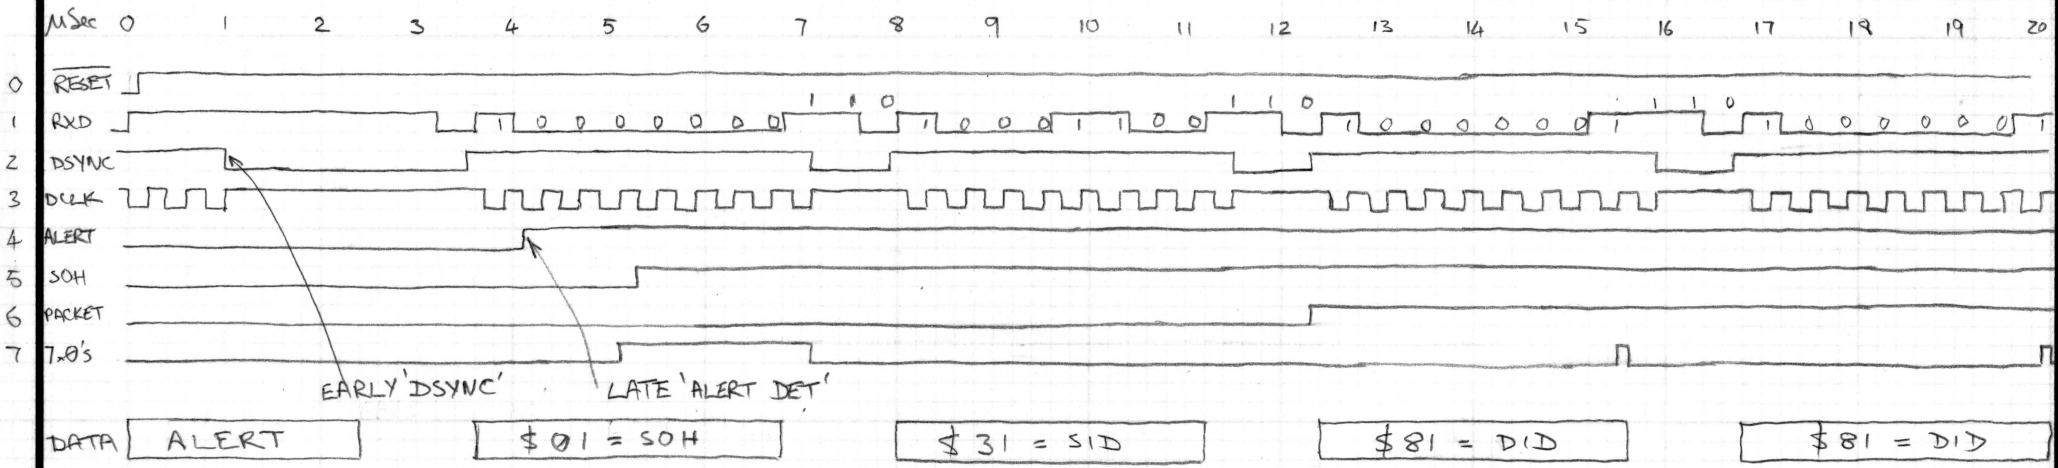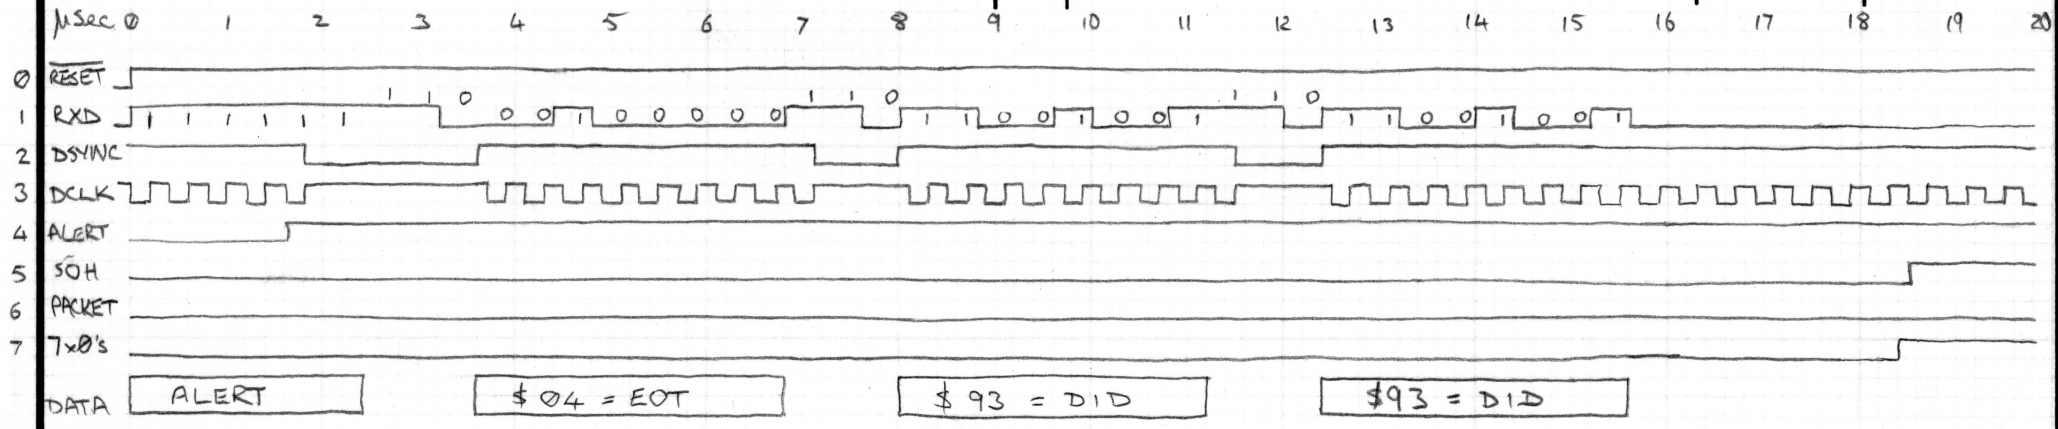


NOTE 'DSYNC' DROPS AFTER ONLY 3 RISING EDGES OF 'DCLK' HOWEVER, AS THE LSB OF 'SOH' IS A '1' THERE ARE STILL 4 CONTIGUOUS '1'S CLOKED INTO THE SHIFT REG. SO 'ALERT DET' IS SET JUST IN TIME TO TRIGGER 'SOH'

TOLERANCES UNLESS OTHERWISE SPECIFIED			SNIFFER WAVEFORMS		
FRACTIONS	DEC	ANGLES	UPPER = TOKEN PASS TO NON-SNIFFER STN		
±	±	±	LOWER = DATA PACKET TO NON-SNIFFER STN		
APPROVALS		DATE			
DRAWN					
CHECKED		SCALE		SIZE	DRAWING NO.
				<b>A</b>	
DO NOT SCALE DRAWING				SHEET 2 of 3	


SCALE = 200 ns/div  
 SNIFFER ADDR = \$8F

REVISIONS			
LTR	DESCRIPTION	DATE	APPROVED

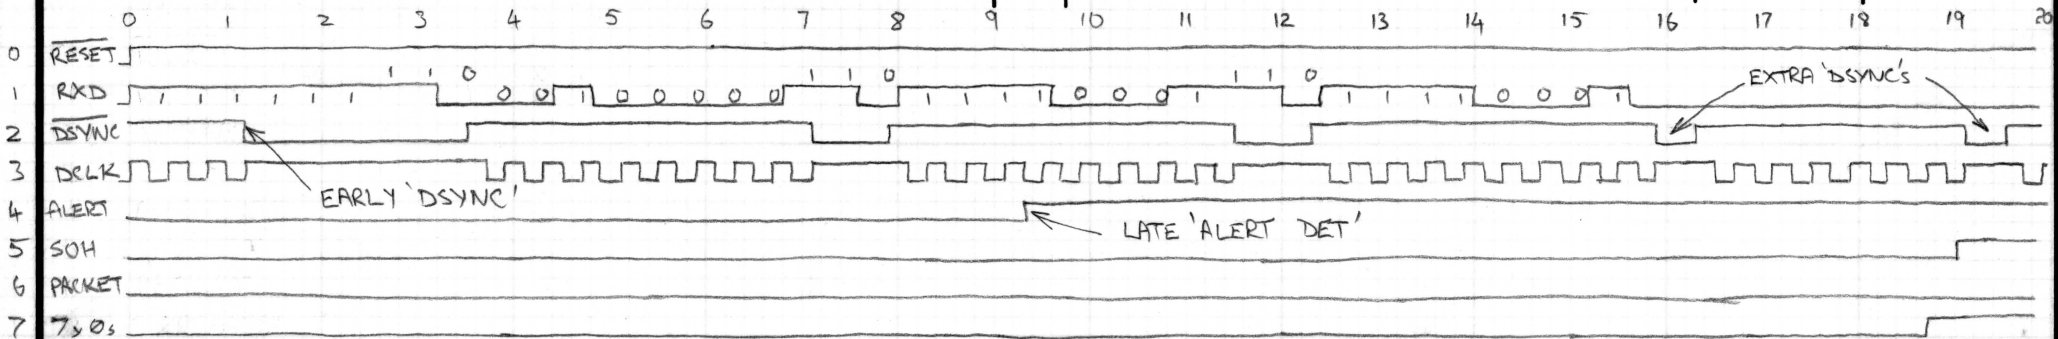

DATA ALERT      \$04 = EOT      \$8F = DID      \$8F = DID

SNIFFER ADDR = \$80

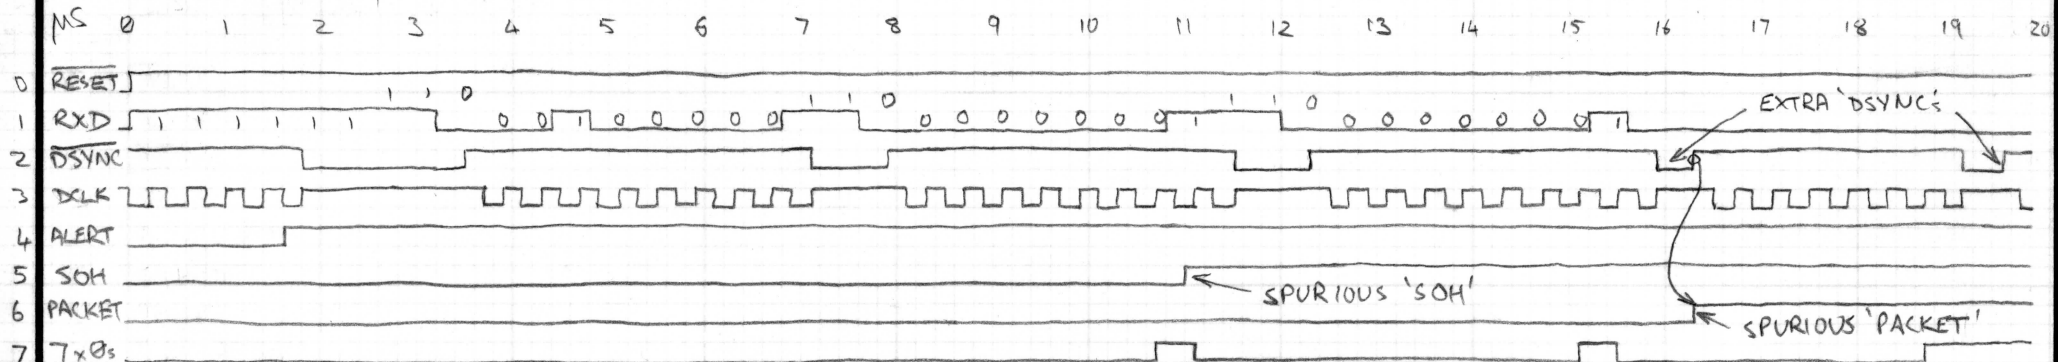

DATA ALERT      \$04 = EOT      \$80 = DID      \$80 = DID

NOTE LOWER W/Fs SHOW 'SPURIOUS' 'PACKET' SIGNAL CAUSED BY SEVEN CONTIGUOUS '1's IN AN ADDRESS GENERATING A SPURIOUS 'SOH'. THE EXTRA 'DSYNC' PULSES OCCUR WHEN THE RIM RECEIVES THE TOKEN & THEY CLOCK 'PACKET'

NOTE UPPER W/F SHOWS HOW 'DSYNC' DROPPING BEFORE 4x '1's OF THE 'ALERT' CAUSES 'ALERT DET' TO BE GENERATED LATE, 'ALERT DET' WILL NOT BE GENERATED AT ALL IF THERE ARE NOT 4 CONTIGUOUS '1's IN THE DIDs OF A TOKEN.

TOLERANCES UNLESS OTHERWISE SPECIFIED		
FRACTIONS	DEC	ANGLES
±	±	±
APPROVALS	DATE	
DRAWN		
CHECKED		

SNIFFER WAVEFORMS (RECEIVING TOKEN)

UPPER W/F STN ADDR = \$8F  
 LOWER W/F STN ADDR = \$80 (BAD)

SCALE	SIZE	DRAWING NO.
	<b>A</b>	
DO NOT SCALE DRAWING		SHEET 3 of 3

File SNIFFER.text on /MAIN/USERS/JHAR/NEWD0C

Hints for using the sniffer.  
-----

The Sniffer board can be placed in any IBM slot and will work in any 64k, basic PC with at least 1 disk drive. The only restriction in the layout in the host machine is that there must be at least 64k of expansion memory contiguous with the 64k on the main system board (i.e. address starting at segment \$1000). The expansion memory need not be declared by the switches as the expansion memory is found by the sniffer initialisation routine. The sniffer can also work as an ordinary NIC so before using it the switches at the top of the board must be turned on (towards the front of the PC). Also the memory segment where the card is placed must be set to \$D200 or else it will not respond to software commands.

To start the board running the Sniffer software disk is placed in the boot disk drive and the machine turned on. After a few whirs and skraunches the user will be required to indicate whether short or long frames are expected. Untill the new RIM's arrive the answer to this will always be 'short'. The sniffer board is then initialised and the number of packets it should hang around for is requested, if 0 is entered the whole of RAM will be filled (each frame takes up 512 bytes so a 256k RAM card will take 512 frames). Pressing any key will cause the receive process to terminate with however many frames it already received safely stored away. When the receive operation finishes, either by pressing a key or else when the required number of packets have been received, the last received frame number is indicated to the user. Working back from this enables the inspection of frame headers and data of all received packets. A displayed menu of choices is given allowing different frames or data to be displayed. The sniffer can be restarted at any point in the display routines and frames then received will be placed after the frames already received in RAM. Should the whole of RAM be filled the program bombs out and tells you so, the sniffer will then have to be restarted and places the new frames at the start of RAM again.

The speed of the sniffer is such that all normal activity in a network can be captured without missing any data or complete frames. However there is a statistical possibility if two adjacent stations send data on the same token 'round', and the first sends a frame with greater than 200 data bytes while the second sends minimum data (50 bytes of header only) that the first packet will have some of its data overwritten by the second frame before it is safely stored away in RAM, though the header will be preserved intact.

JHAR


5th november 1982




IBM PC NIC

REVISIONS				
ZONE	REV	DESCRIPTION	DATE	APPROVED
	A	MODIFY TO USE ZYNAR REV B BOARD ADOPT LS00 FOR NIC/SNIFFER EXCHANGE	10.25.83	<i>[Signature]</i>
	B	ADD SNI-9 & CHANGE USAGE OF IC2	11.10.83	<i>[Signature]</i>
	C	ALERT Det. Cct. changed (IC3/2 → PU)	8-9-83	<i>[Signature]</i> 10/17/84


D

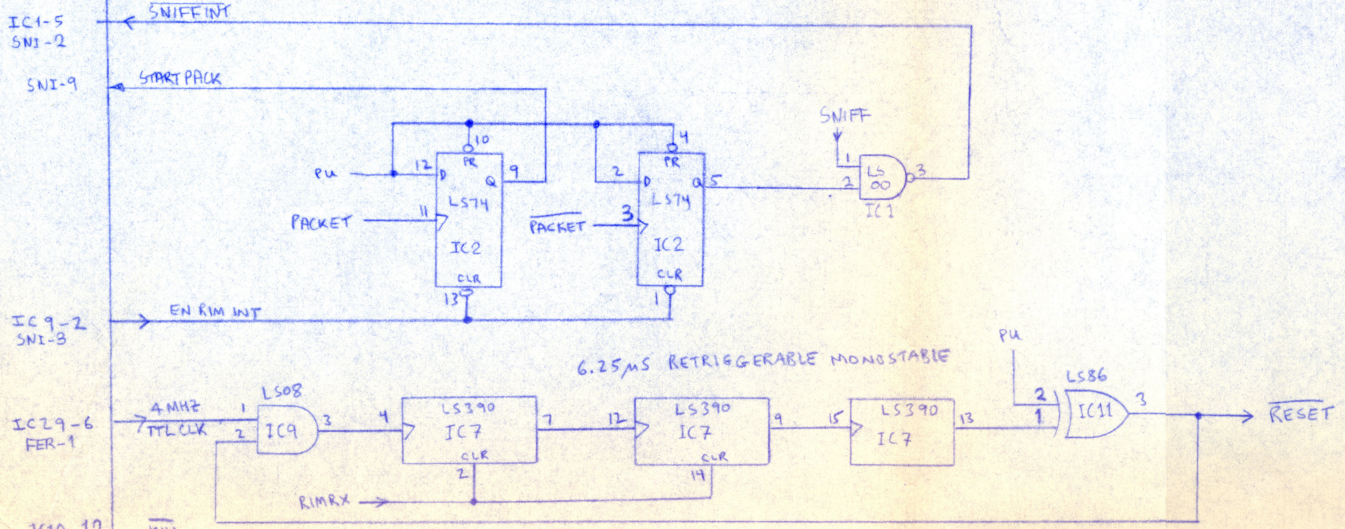


C

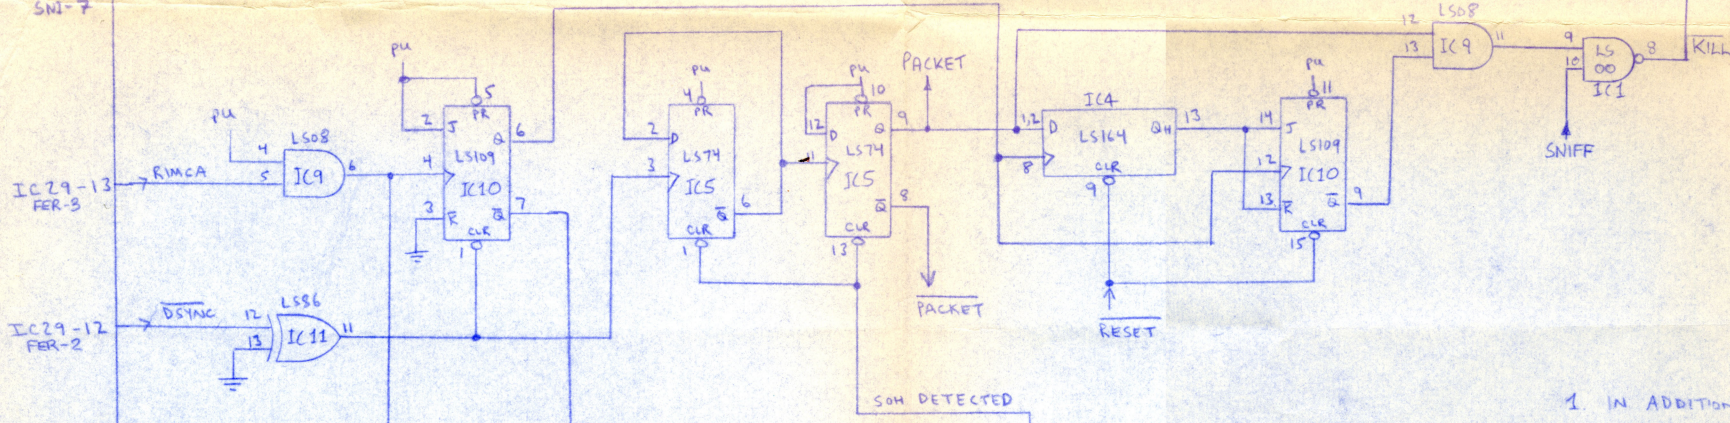

B

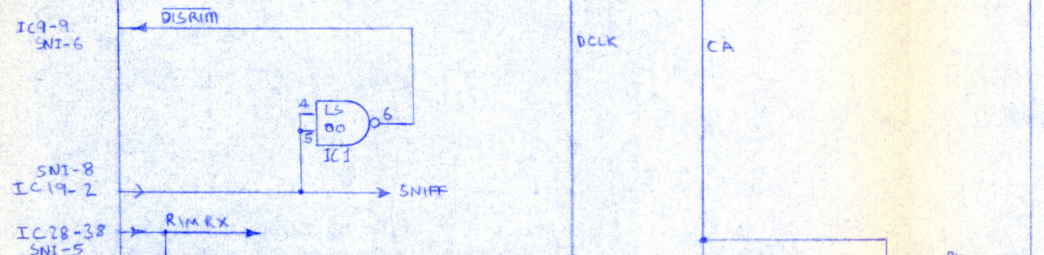

A

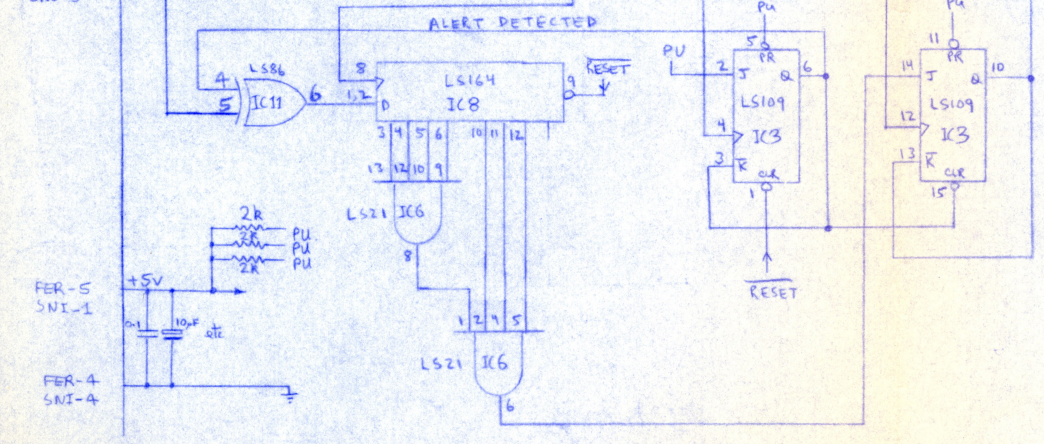



1. IN ADDITION TO THE 12 CONNECTIONS TO THE HEADERS OF THE REV B ZYNAR NIC (IBMPC), IC19-2 MUST BE CONNECTED VIA FLYING LEAD OR USE OF ONE POWER CONNECTION PIN (PER-5 OR SNI-1)
2. THE NIC ACTS NORMALLY AT POWER ON, AND BECOMES A SNIFFER ONLY WHEN BIT DO (LSB) OF THE CONTROL REGISTER (XXX080Z) IS SET ON.
3. STARTPACK SIGNAL IS UNUSED, ADDED SIMPLY FOR FUTURE USE IF DESIRED.

PROPRIETARY INFORMATION  
NESTAR SYSTEMS, INCORPORATED

QTY	FSCM	PART OR IDENTIFYING NO.	NOMENCLATURE OR DESCRIPTION	MATERIAL SPECIFICATION
PARTS LIST				
UNLESS OTHERWISE SPECIFIED DIMENSIONS ARE IN INCHES TOLERANCES ARE:			CONTRACT NO.	
FRACTIONS	DECIMALS	ANGLES	APPROVALS	
-	XX-	XXX-	DATE	
MATERIAL ORIGINAL BY CHRIS READ, ZYNAR			DRAWN L. SHUSTER 9/20/83	
FINISH			CHECKED	
NEXT ASSY			ISSUED	
USED ON			SIZE C FSCM NO.	
APPLICATION			DWG. NO.	
DO NOT SCALE DRAWING			REV. C	
			SCALE	
			SHEET 1 of 1	



REVISIONS			
LTR	DESCRIPTION	DATE	APPROVED

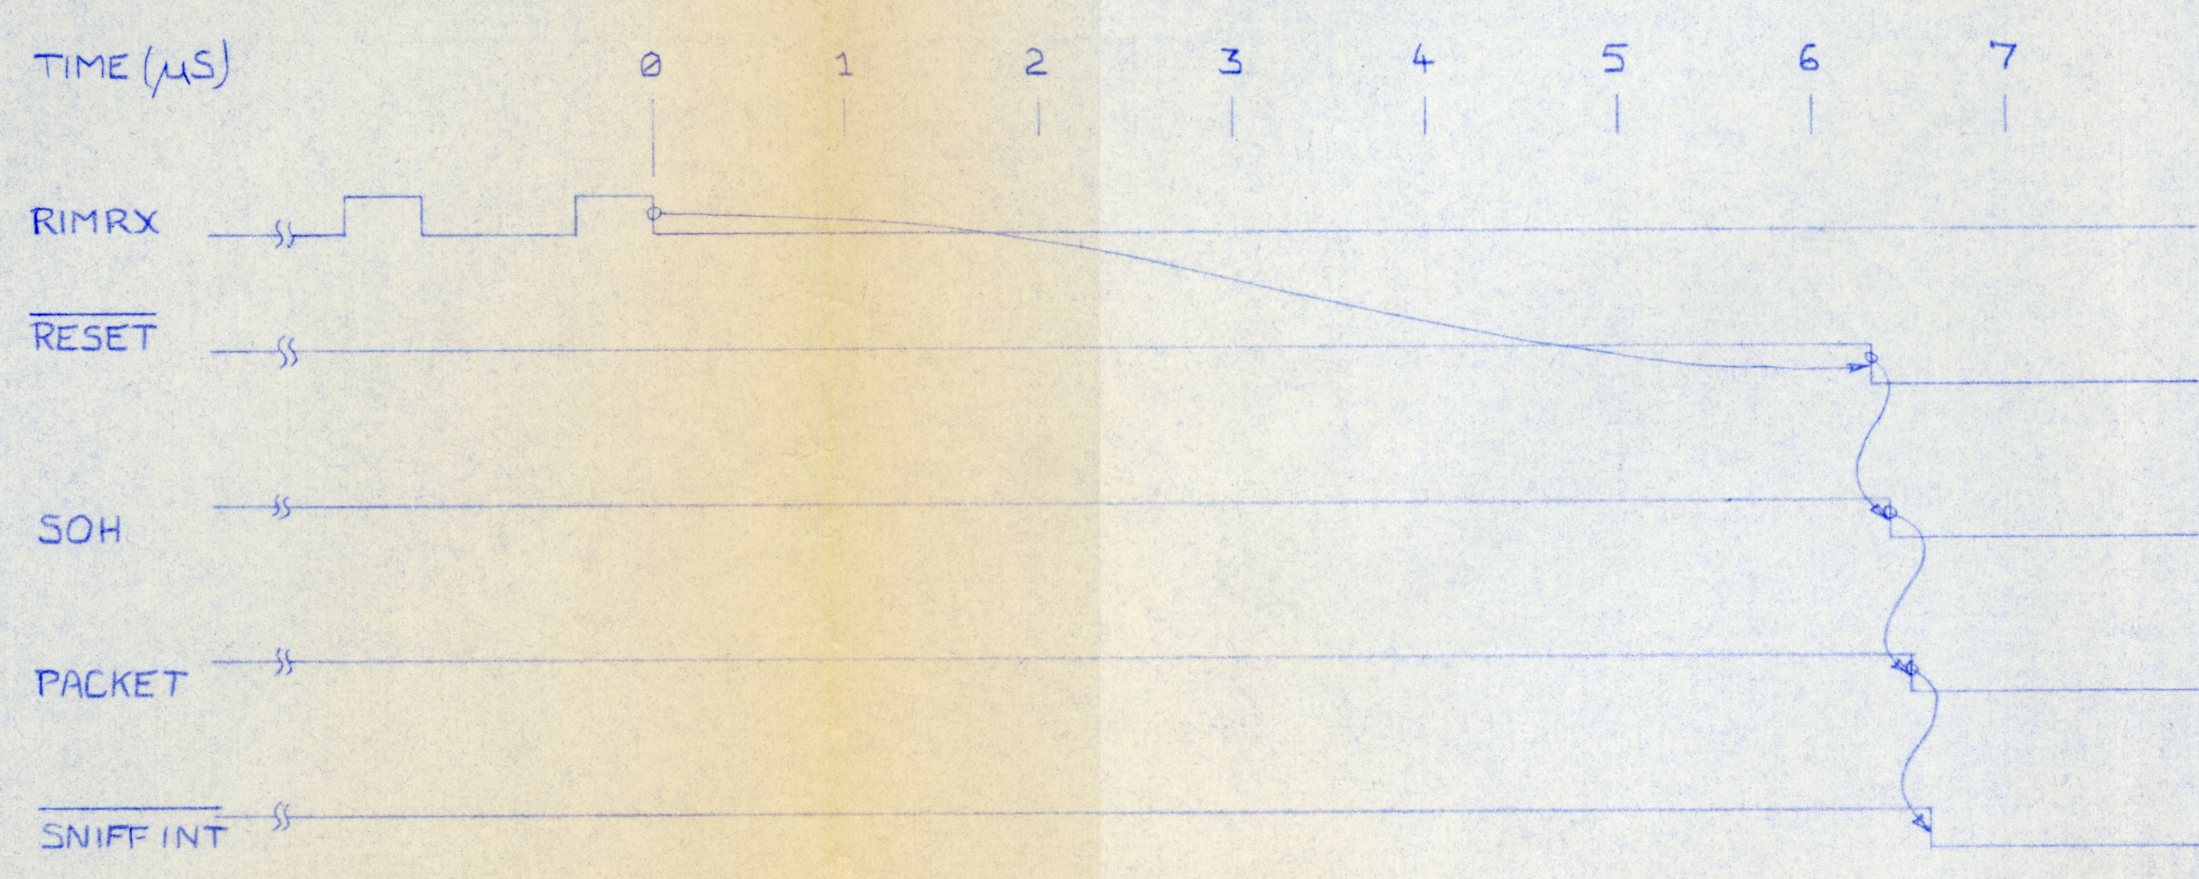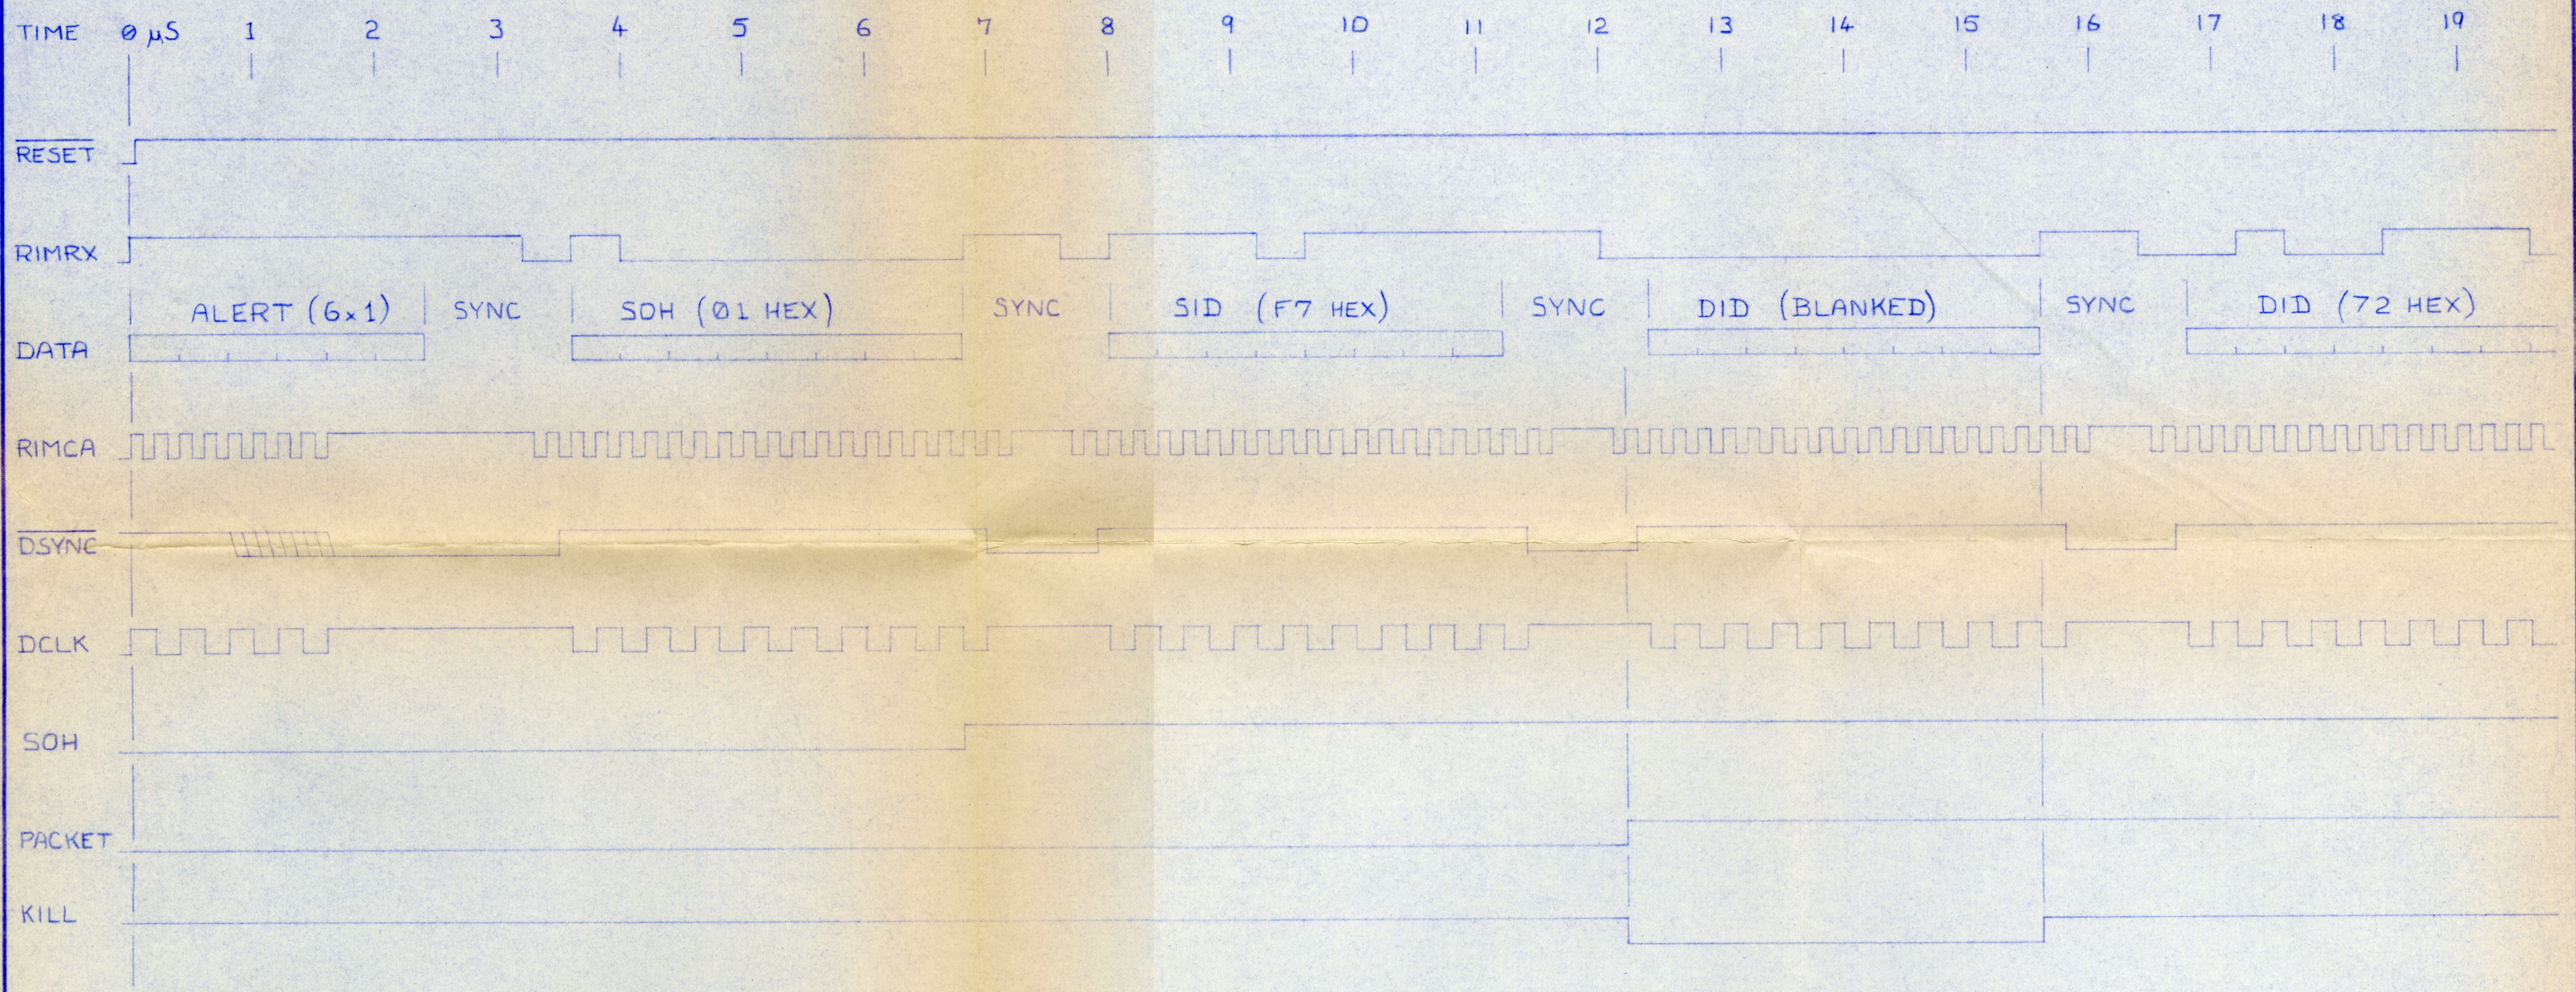

TOLERANCES UNLESS OTHERWISE SPECIFIED			
FRACTIONS	DEC		
±	±	±	<b>SNIFFER TIMING</b>
APPROVALS	DATE	SCALE	
DRAWN <i>[Signature]</i>	10/27/84	SIZE <b>C</b>	DRAWING NO.
CHECKED		DO NOT SCALE DRAWING	
			SHEET 1 of 1



©Nestar Zynar 82.83 10639-002 REV

4397

made in USA

IC1

T74LS14BI  
98345

IC6

SN74LS125AN  
18348

IC11

74LS260N K8347  
5A

IC16

74LS373M K8310  
5A

IC21

AM9128-15PC  
8622WPP

RP4

MDP1603-470G  
DALE 8326

IC28

SARONIX 83  
XTAL OSC 52  
20.0000 MHz  
NCT050C

IC34

CON9032  
SIC  
8352B

IC2

SN74LS33JD  
18326

IC7

74LS32N K8339  
5A

IC12

SN74LS244N  
RQ8324

IC17

74LS244N X8347  
5A

IC22

RP3

MDP1603-470G  
DALE 8326

COM9026  
SMD8405A

IC3

74LS02N K8347  
5A

IC8

SP8338\*  
DM74LS74AN

IC13

TIP285-2N  
SINGAPORE  
ZYNAR 83  
71128A

IC18

PORTUGAL 8336A  
SN74LS373N

IC23

MB8128-15  
JAPAN 8224 F36

RP5

MALAYSIA 340A  
SN74LS123N

1 2 3 4 5 6 7 8  
OPEN

IC4

J325BAC  
SN74LS74AN

IC9

74LS08N K8351  
5A

IC14

SN74LS244N  
RQ8324

IC19

74LS273N V8347  
5A

IC24

PR253-5  
LG110560  
INTEL '86

RP6

MALAYSIA 340A  
SN74LS123N

1 2 3 4 5 6 7 8  
OPEN

IC5

74LS32N K8339  
5A

IC10

CD74HCT08E  
RCA H 436

IC15

74LS32N K8339  
5A

IC20

SN74LS244N  
RQ8324

IC25

PR253-5  
LG110560  
INTEL '86

RP7

MALAYSIA 340A  
SN74LS123N

1 2 3 4 5 6 7 8  
OPEN

























































































































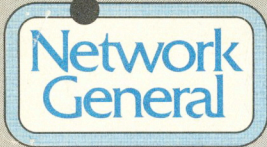

ARCNET SNIFFER S/N 4397

REV 001

Copyright 1986, 1987, Network General Corp. All rights reserved

